


TAX LOT 500

TAX LOT 902

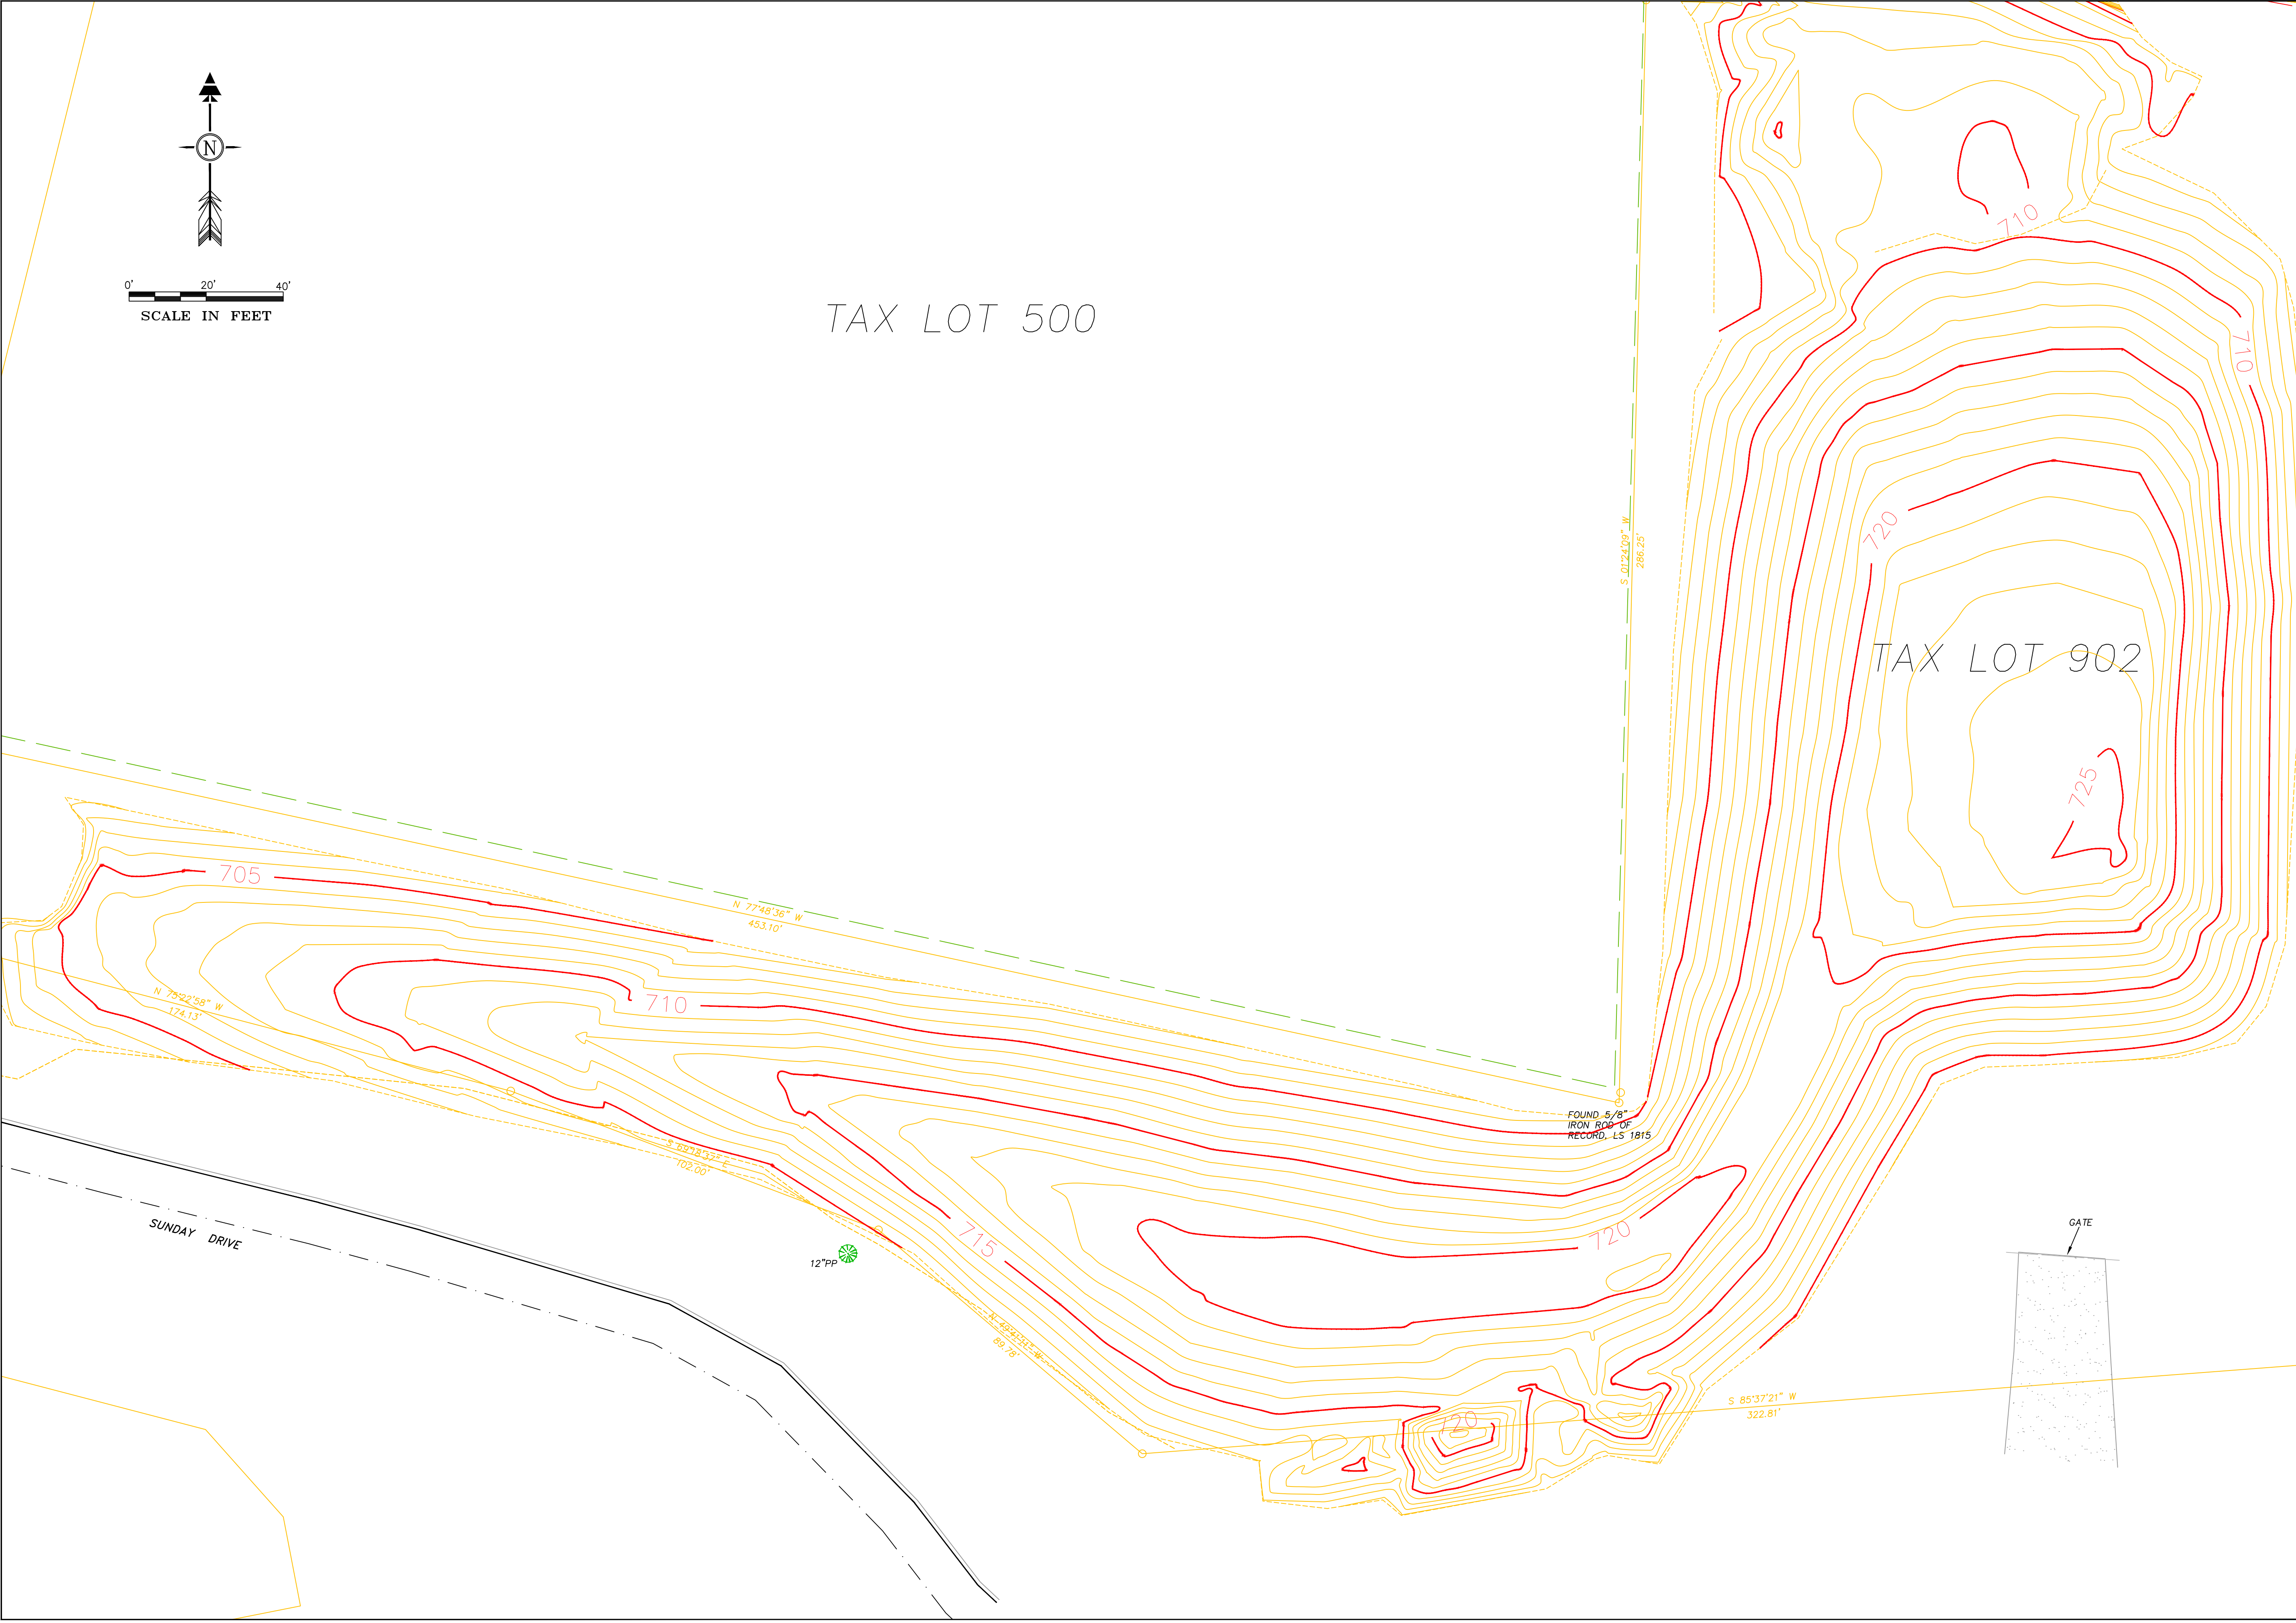

SURFACES PORT OF HOOD RIVER LOWER HANEL MILL ODELL, OREGON 97044		VISTA GEOENVIRONMENTAL SERVICES 489 N 8TH STREET - SUITE 201 HOOD RIVER, OREGON 97031 (541)386-3680	
DRAWING NO. 2		DATE: 10/22/18	
WOOD DEBRIS STOCKPILE AS-BUILT		15-104	
REV	DATE	REVISION DESCRIPTION	DESIGN APP
-	-	-	-
-	-	-	-
